


DRILL HOLES


BORDER REV. DATE: June 1, 2004

PROPOSED SIGNS

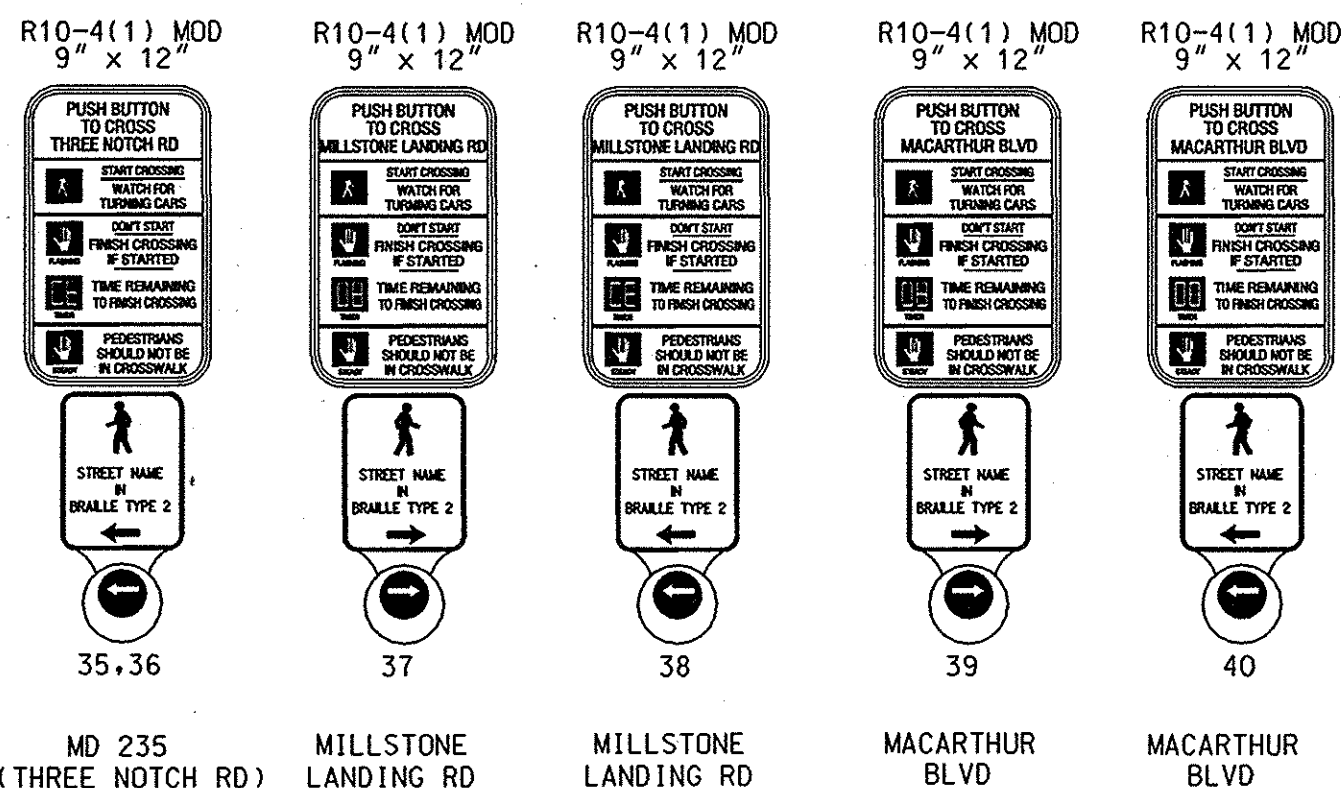


NOTE: MD 235 IS CONSIDERED TO RUN IN A NORTH-SOUTH DIRECTION.


PROPOSED SIGNALS

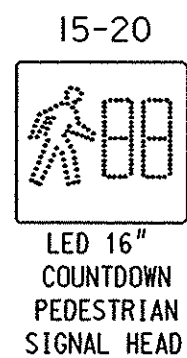

SIGNS

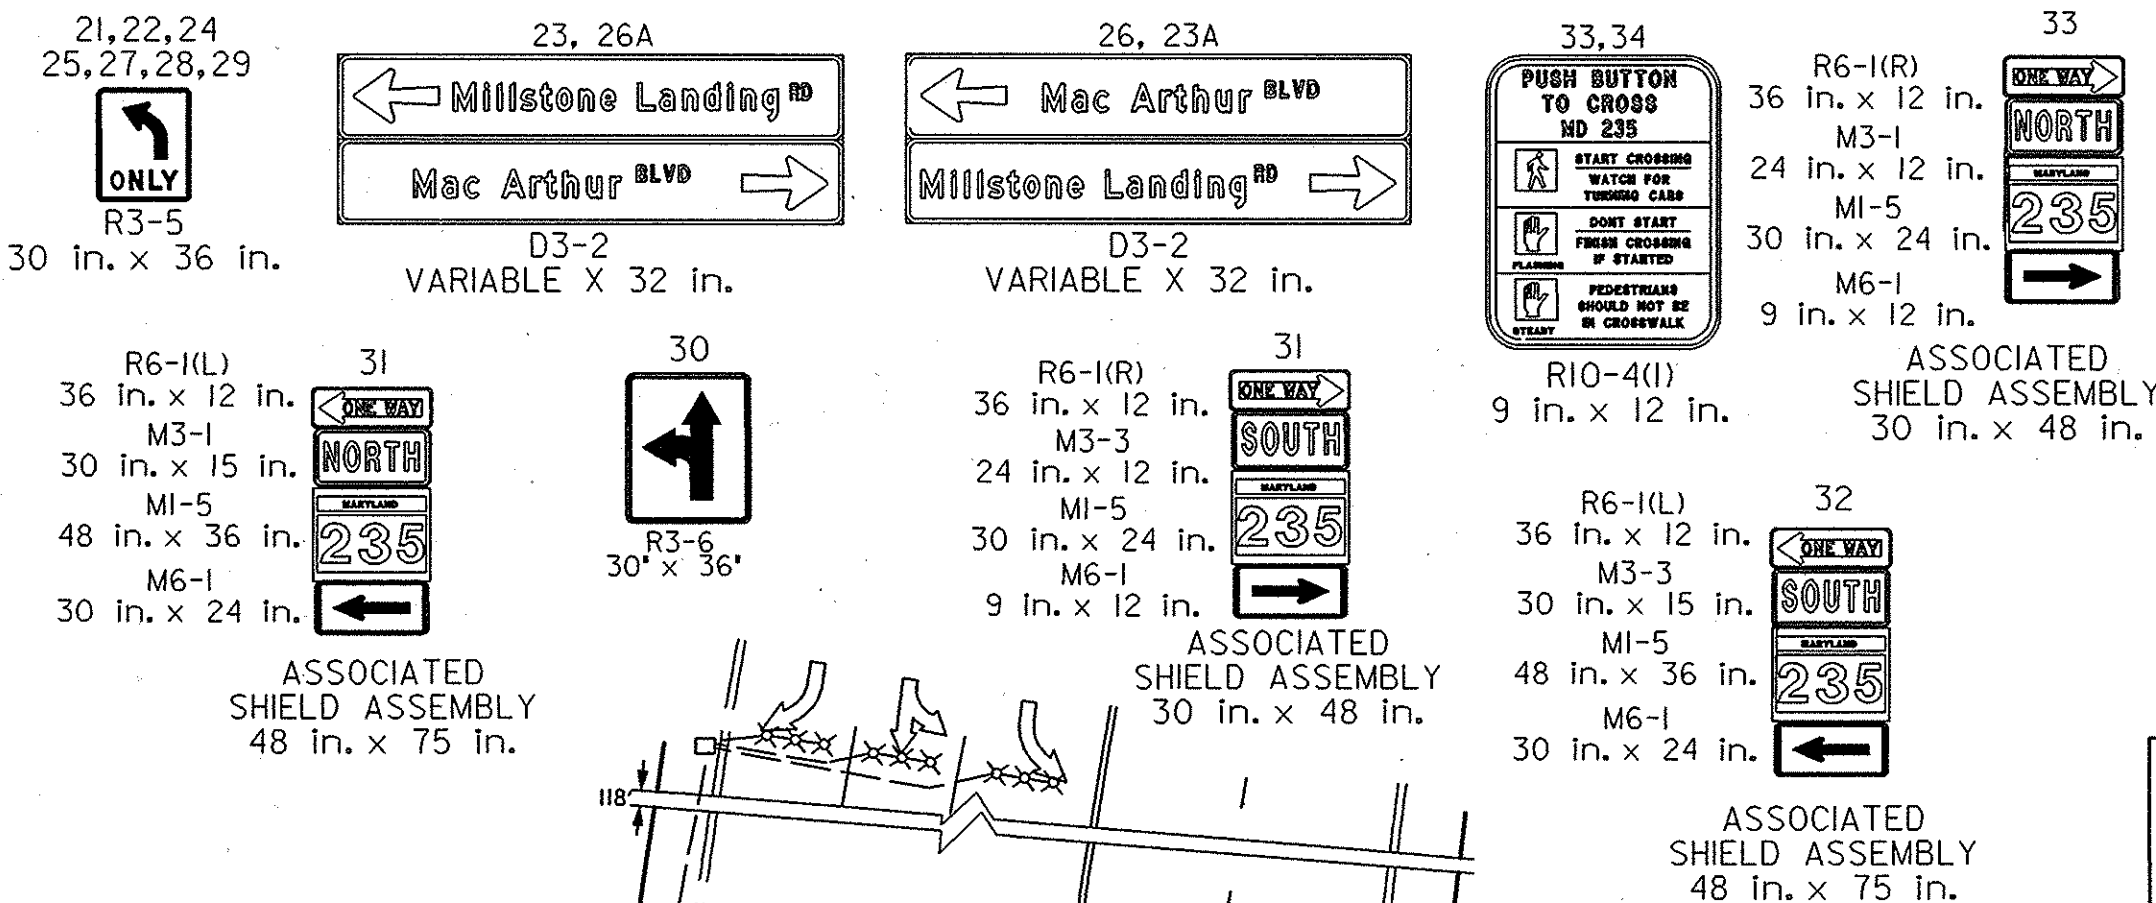


SIGNALS

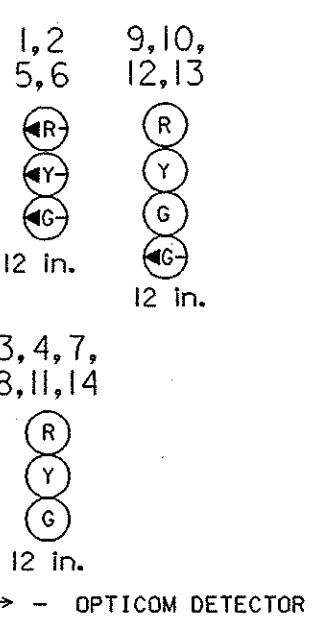

PHASING NOTES:
1. PHASES ASSOCIATED BY A SOLID LINE WILL NOT OPERATE CONCURRENTLY.
2. PHASES ASSOCIATED BY A DASHLINE MAY/WILL OPERATE CONCURRENTLY.

GENERAL NOTES:

- All underground utilities shown on these plans are schematic only and may not be complete. The contractor shall be responsible for notifying "MISS UTILITY" prior to construction so that all utilities may be located in the field. If the contractor perceives that a conflict between the utilities and the traffic signal will occur, the contractor shall notify the project engineer immediately so that the conflict may be resolved.
- All pavement markings detailed are proposed and are to be installed in accordance with SHA standards.
- All Traffic Signal Foundations shall be installed at the Final Sidewalk or Curb grade for closed sections, Highest Roadway Profile Grade for open sections, to meet clearances as specified in MD 815.03, MD 818.01, MD 818.02, and MD 818.04. The contractor shall verify ultimate grades prior to the installation of all signal equipment.
- The contractor shall remove all unused wiring.
- If the location of Accessible Pedestrian Signal Pushbuttons must be changed, the contractor shall notify the Project Engineer to get approval for new location to ensure proper requirements of the MUTCD are still met. All work must be halted until the Project Engineer has obtained an approved location or if necessary a design waiver is obtained.

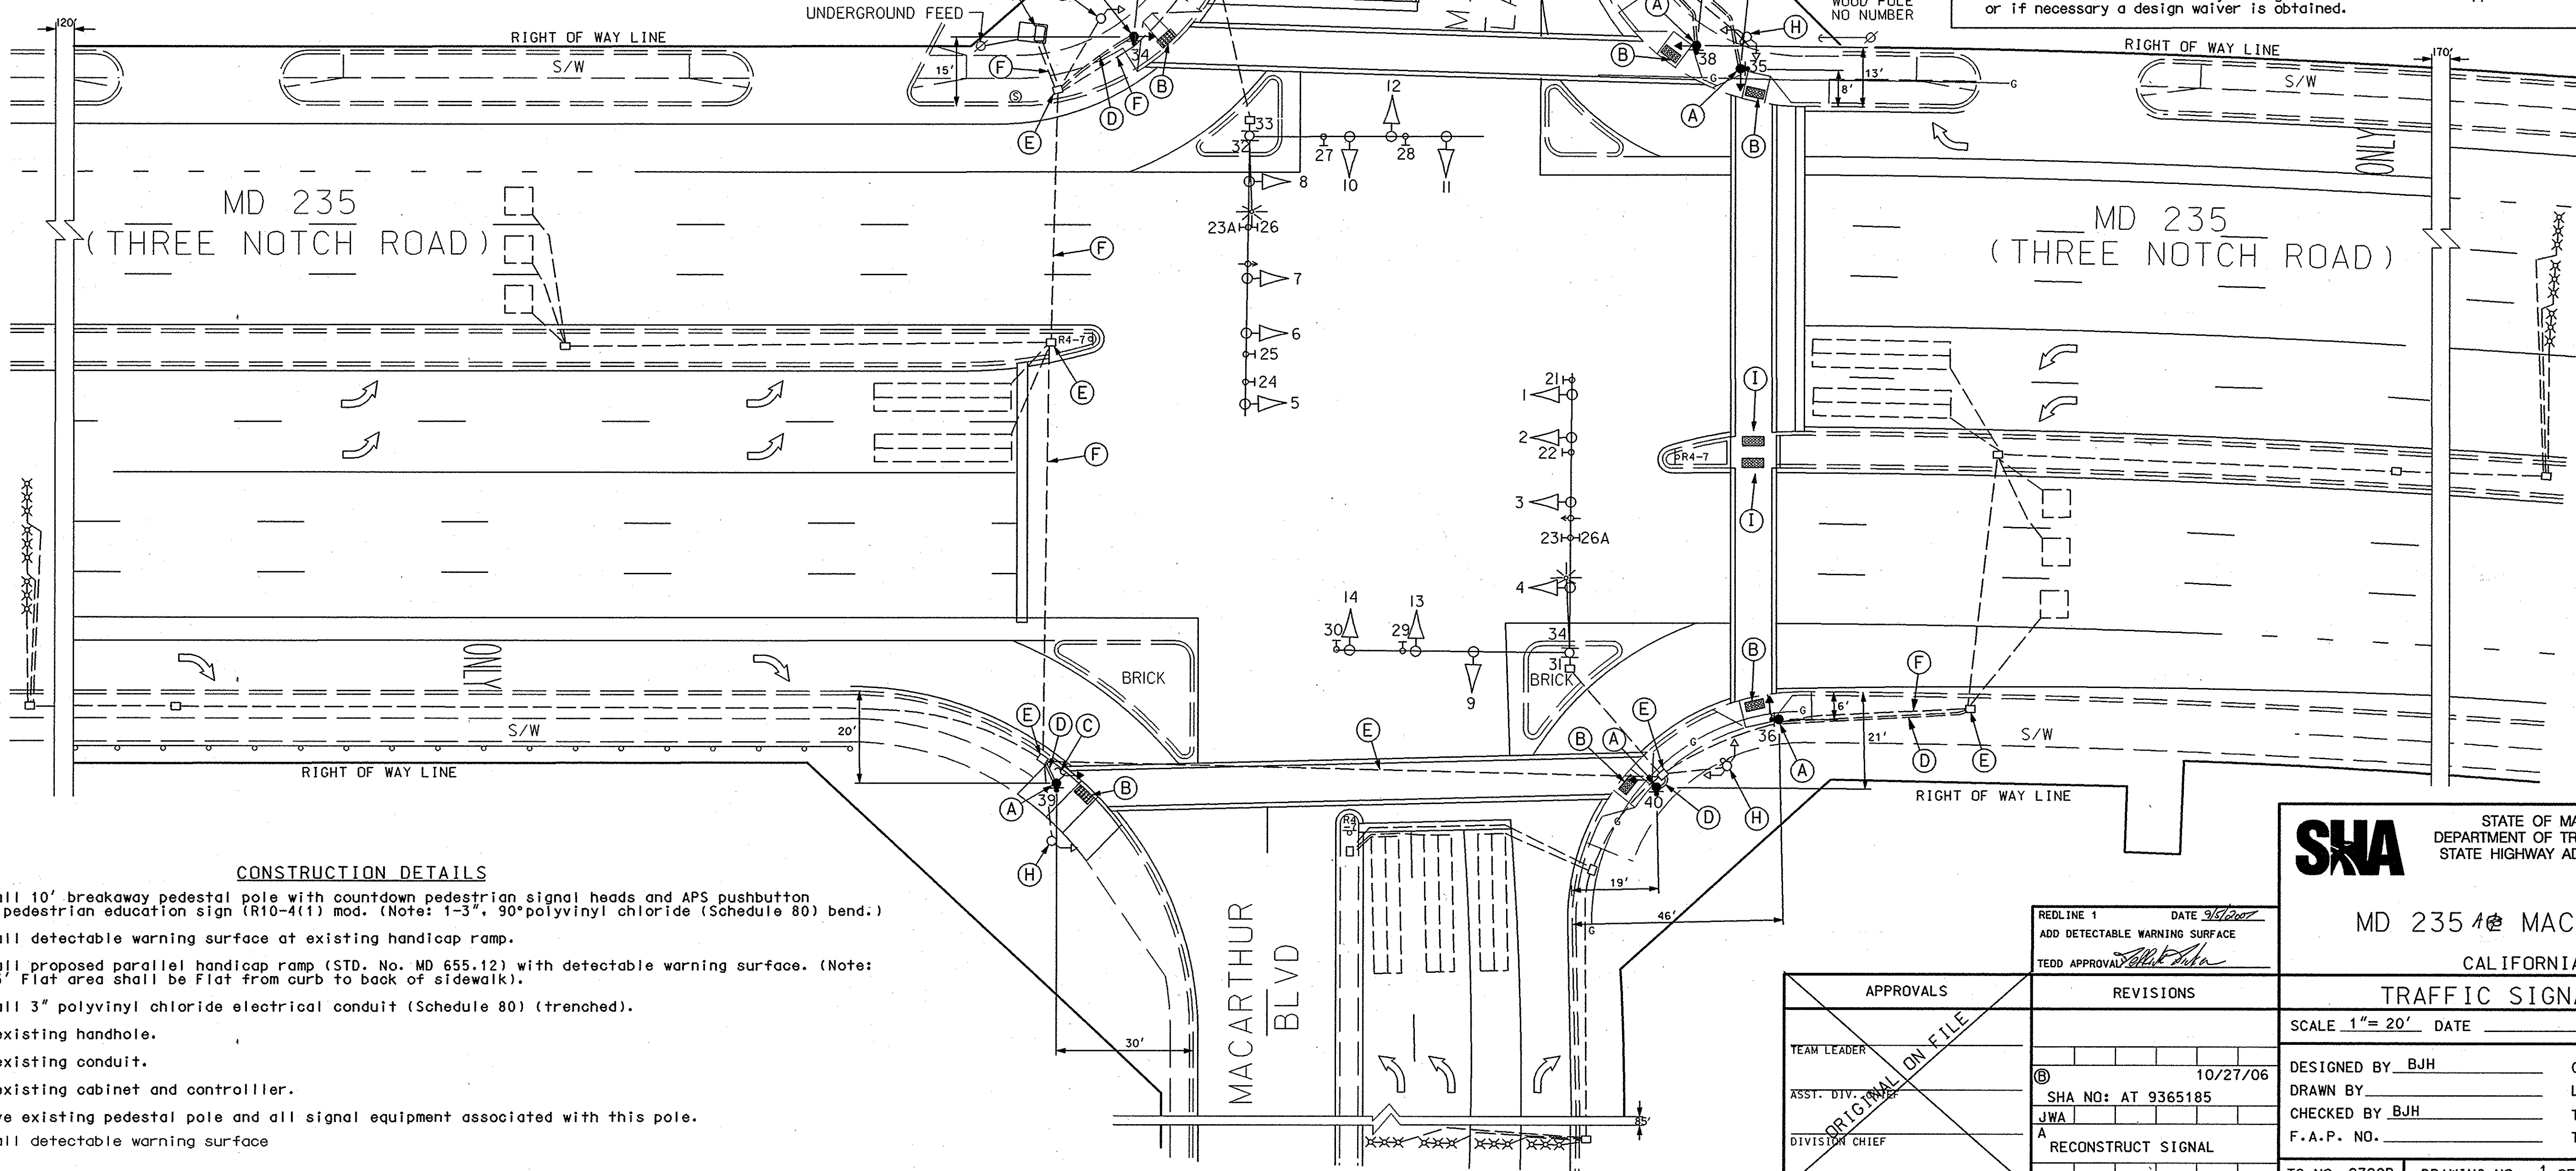

CONSTRUCTION DETAILS


- Install 10' breakaway pedestal pole with countdown pedestrian signal heads and APS pushbutton with pedestrian education sign (R10-4(1) mod. (Note: 1-3", 90° polyvinyl chloride (Schedule 80) bend.)
- Install detectable warning surface at existing handicap ramp.
- Install proposed parallel handicap ramp (STD. No. MD 655.12) with detectable warning surface. (Note: The 5' Flat area shall be Flat from curb to back of sidewalk).
- Install 3" polyvinyl chloride electrical conduit (Schedule 80) (trenched).
- Use existing handhole.
- Use existing conduit.
- Use existing cabinet and controller.
- Remove existing pedestal pole and all signal equipment associated with this pole.
- Install detectable warning surface

GEOMETRIC LEGEND

PROPOSED
EXISTING

LEGEND OF UNDERGROUND AND OVERHEAD UTILITIES

AERIAL CABLE
ELECTRIC
TELEPHONE
GAS
SEWER
WATER
CABLE TV

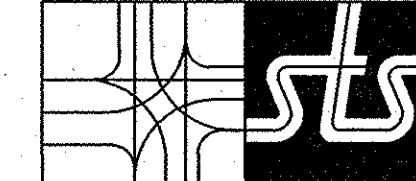

STREET TRAFFIC STUDIES, LTD.
602 Crain Hwy. N.E.
Glen Burnie, MD 21061
PH (410) 590-0500
Fax (410) 590-6637

5042d.dgn



STATE OF MARYLAND
DEPARTMENT OF TRANSPORTATION
STATE HIGHWAY ADMINISTRATION

MD 235 @ MACARTHUR BLVD.

CALIFORNIA, MD

TRAFFIC SIGNAL PLAN

SCALE 1"= 20' DATE CONTRACT NO.

DESIGNED BY BJH COUNTY ST. MARY'S

DRAWN BY LOGMILE 18023514.43

CHECKED BY BJH TMS NO. F200

F.A.P. NO. TOD NO.

TS NO. 2320B DRAWING NO. 1 OF 2 SHEET NO. OF

REDLINE 1
ADD DETECTABLE WARNING SURFACE
TEDD APPROVAL

REVISIONS

DATE 10/27/06

SHA NO: AT 9365185

JWA

RECONSTRUCT SIGNAL

APPROVALS

TEAM LEADER

ASST. DIV. CHIEF

DIVISION CHIEF

OFFICE DIRECTOR

PLOTTED: FRIDAY, AUGUST 17, 2007 AT 10:09 AM
FILE: J:\DATA\2007\REDLINE REV\5042D.MACARTHURREDLINE.DGN